

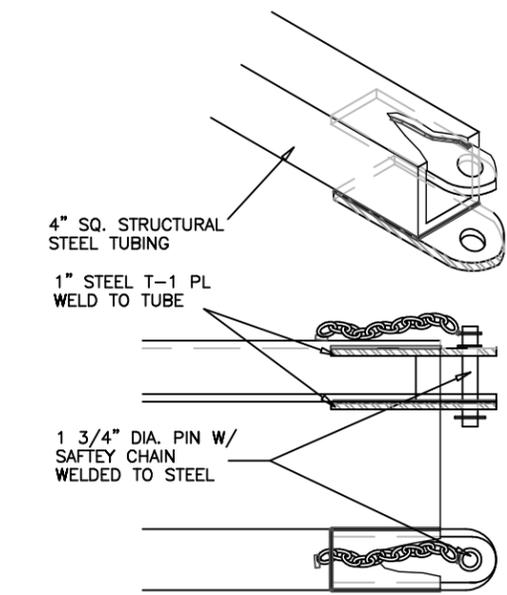


1 3 DRILL CART TRAILER

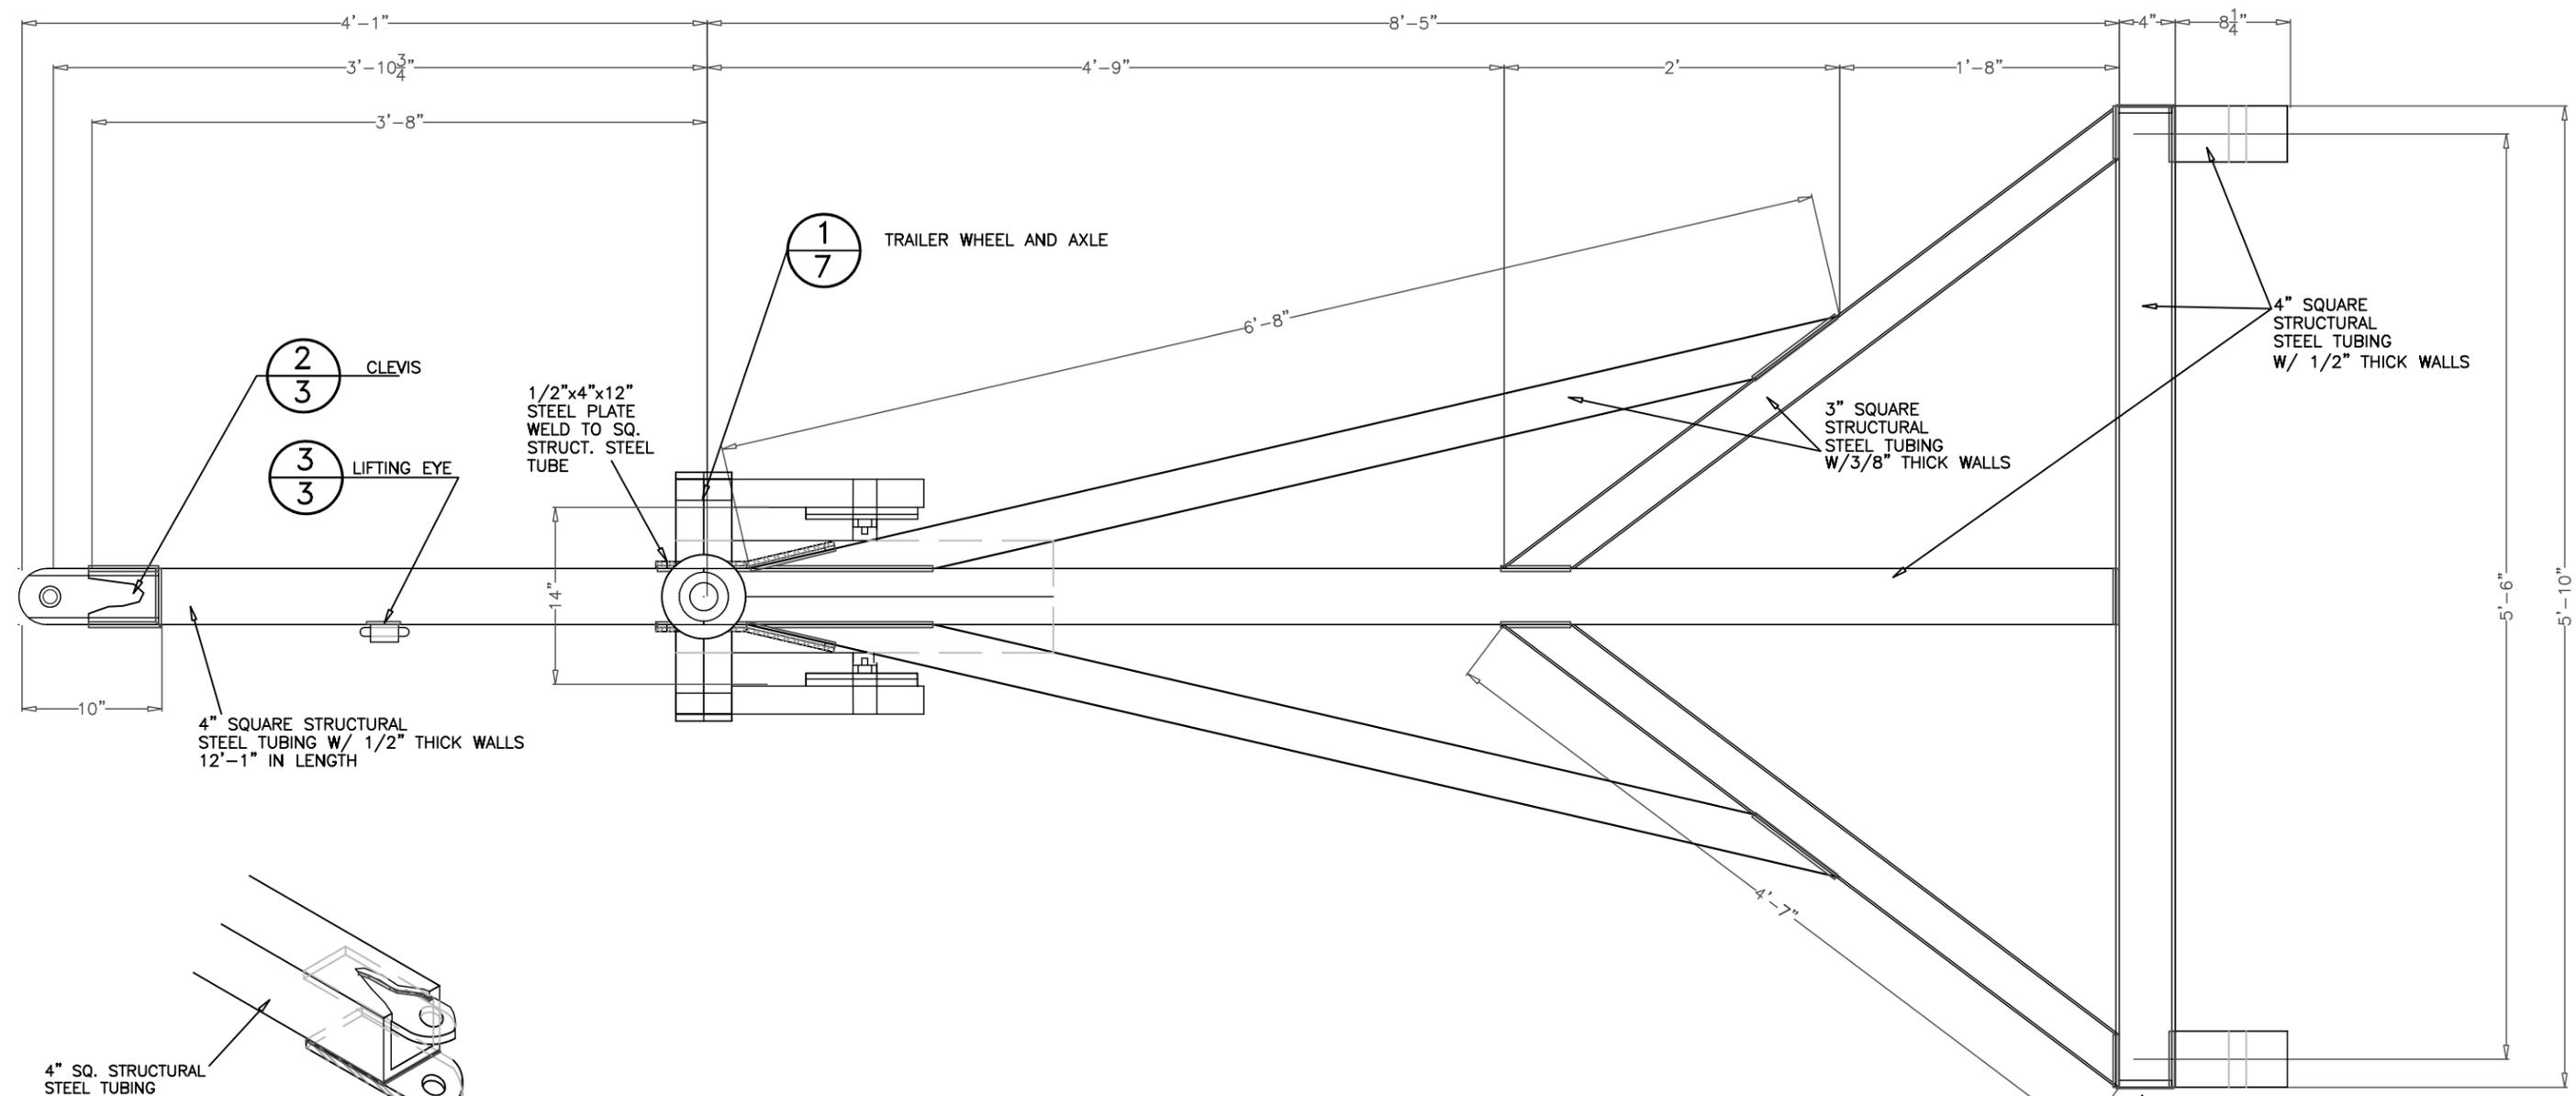

2
3 CLEVIS

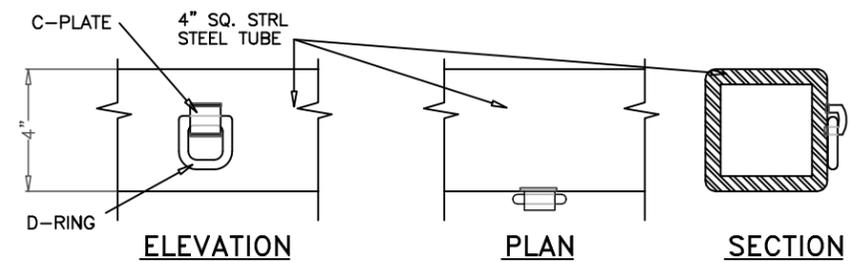

3
3 LIFTING EYE

BOX END OF TUBE
W/ 1/2" STEEL PLATE
INSET IN TUBE END &
WELDED AROUND (TYP)

REV. NO.	DESCRIPTION	DATE	APPROVED
UNITED STATES DEPARTMENT OF THE INTERIOR BUREAU OF LAND MANAGEMENT			
VALE DISTRICT		OREGON	
THREE DRILL CART TRAILER PLAN			
DESIGNED	_____		
REVIEWED	_____		
APPROVED	_____		
<small>CHIEF, BRANCH OF ENGINEERING OR DISTRICT ENGINEER</small>			
DRAWN: CG	SCALE:	_____	
DATE: 05/21/08	SHEET 3	OF 8	_____
DRAWING NO.			

3-CART-DRILL-TRAILER AS BUILT

ACAD2006