(See Map D-17 and D-22 for Map continuation)

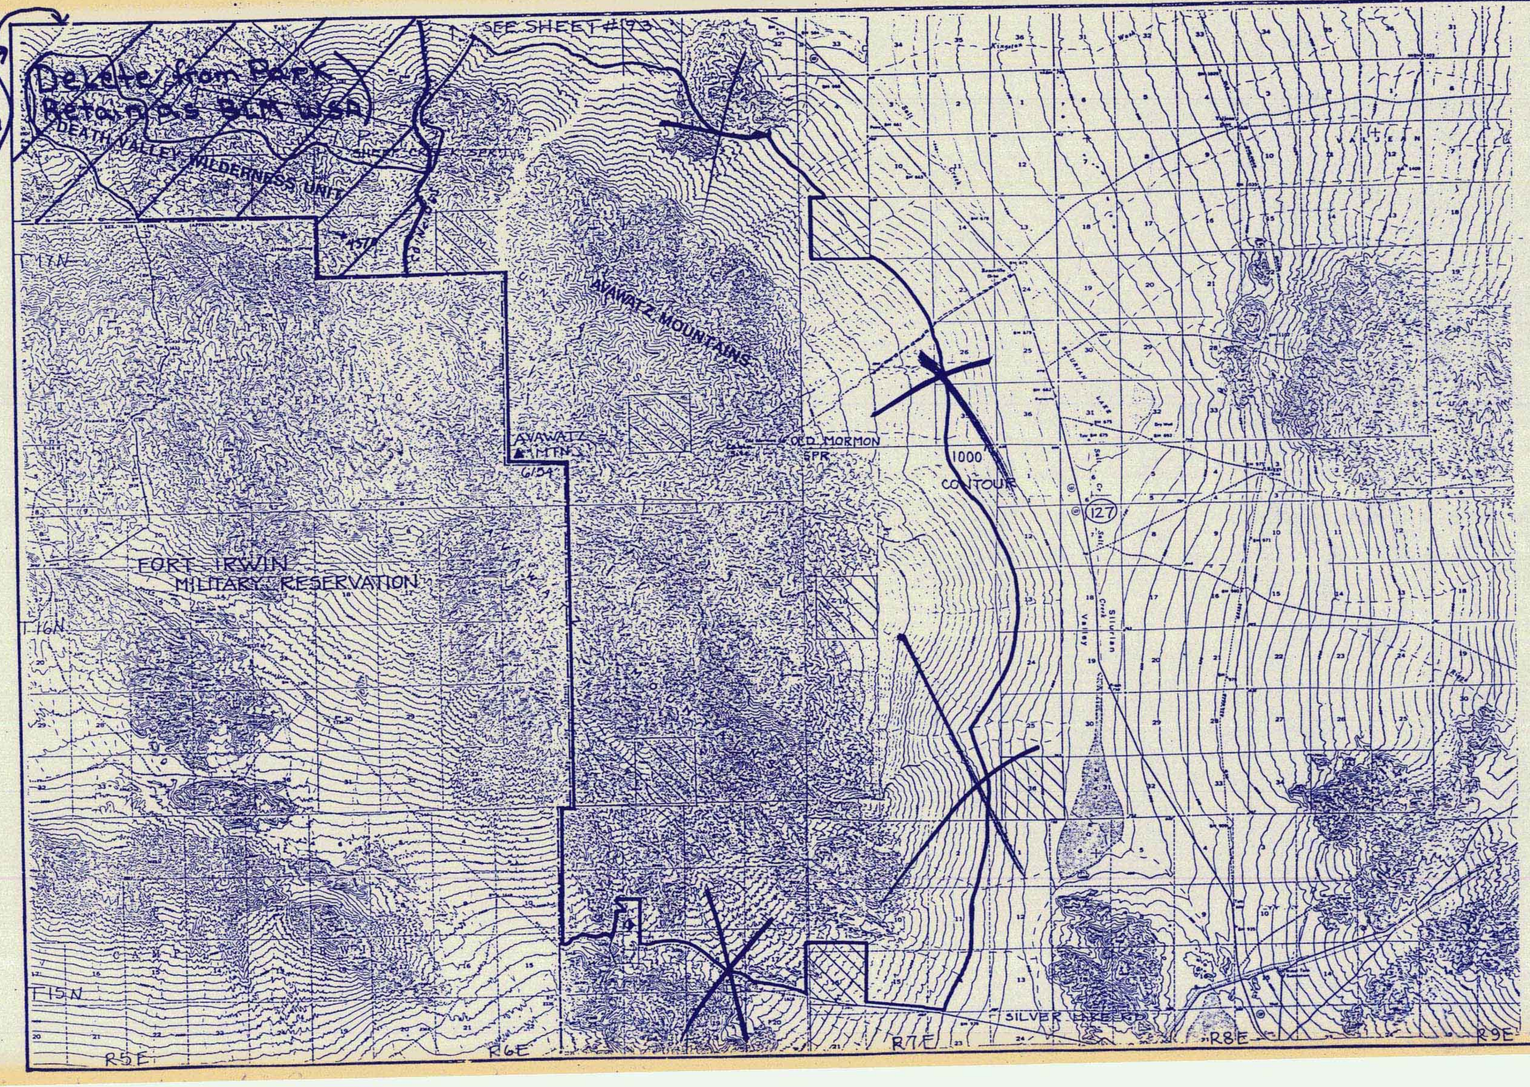

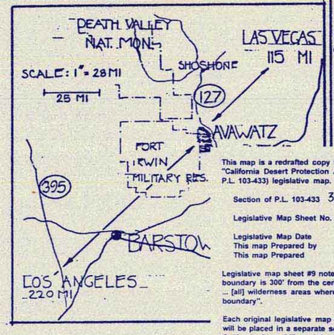

Sec. 302
Sec. 601 (a)(1) PB JF
(Sec. 104(b)(5))
(note: text in parenthesis and crosshatch was not on original Legislative Maps. Text and crosshatch was added for clarification after conversation with Kathy Lacey of Senator Feinstein's staff 11/2/94. See map D-3 for full deletion)

This map is a redrafted copy from the corresponding "California Desert Protection Act" (portion of P.L. 103-433) legislative map.

Section of P.L. 103-433 302, 601(a)(1), 104(b)(5)

Legislative Map Sheet No. D-23

Legislative Map Date May 19 91
This map Prepared by BC, PB, JF, & CR
This map Prepared November 3, 1994

Legislative map sheet #9 notes that "Wilderness boundary is 300' from the centerline of State highway for ... [all] wilderness areas where state highway is the boundary".

Each original legislative map from Titles I, II, VII, and VIII will be placed in a separate serialized case file at the California State Office of the Bureau of Land Management in Sacramento CA. Each original legislative map from Title III through VI will be maintained at the Regional Office of the National Park Service in San Francisco, CA.

Those original legislative maps and other portions of the legislative record will be the basis for preparing the "Map and Legal Descriptions" required at Sections 103(b), 201(c), 304, 404, 504, and 602.

TOTAL AREA = 69,000
STATE = 2,560

23,040
23,040
50

23

PARK BOUNDARY
WILDERNESS BOUNDARY
(NONE) B.L.M. PROPOSED BOUNDARY
STATE LINE
COUNTY LINE
ROADS
UNIMPROVED DIRT TRACK
MAJOR DRAINAGE
INTERSTATE ROUTE
OTHER ROUTES
PRIVATE LAND
BUREAU OF RECLAMATION
AREA OF SPECIAL CONCERN
STATE OF CALIFORNIA
PEAK
MINE

COINCIDES - PARK BOUNDARY COINCIDES WITH PARK WILDERNESS AND BLM WILDERNESS BOUNDARY

SCALE: 1" = 1 MILE

NORTH

USGS 15' TOPOS: AVAWATZ PASS, SILURIAN HILLS, RED PASS LAKE, BAKER

DEATH VALLEY NA PARK BOUNDARY AN WILDERNESS - PROPO

(FORMERLY: AVAWATZ MTNS WILDERNESS)

SHEET	DATE
~~6~~ D-23	~~5-1-85~~ ~~Feb 86~~ May 91