Sec. 104(b)(3) PB/SY

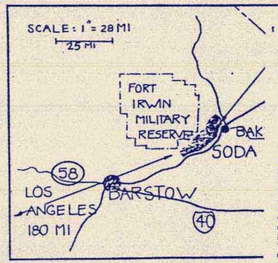

This map is a redrafted copy from the corresponding "California Desert Protection Act" (portion of P.L. 103-433) legislative map.

Section of P.L. 103-433	104(b)(3)
Legislative Map Sheet No.	94
Legislative Map Date	May 1991
This map Prepared by	BC, PB, JF, & CR
This map Prepared	November 3, 1994

Legislative map sheet #9 notes that "Wilderness boundary is 300' from the centerline of State highway for ... [all] wilderness areas where state highway is the boundary".

Each original legislative map from Titles I, II, VII, and VIII will be placed in a separate serialized case file at the California State Office of the Bureau of Land Management in Sacramento CA. Each original legislative map from Title III through VI will be maintained at the Regional Office of the National Park Service in San Francisco, CA.

Those original legislative maps and other portions of the legislative record will be the basis for preparing the "Map and Legal Descriptions" required at Sections 103(b), 201(c), 304, 404, 504, and 602.

TOTAL AREA = 102,500 ACRE
STATE = 5,330
PRIVATE = 4,480

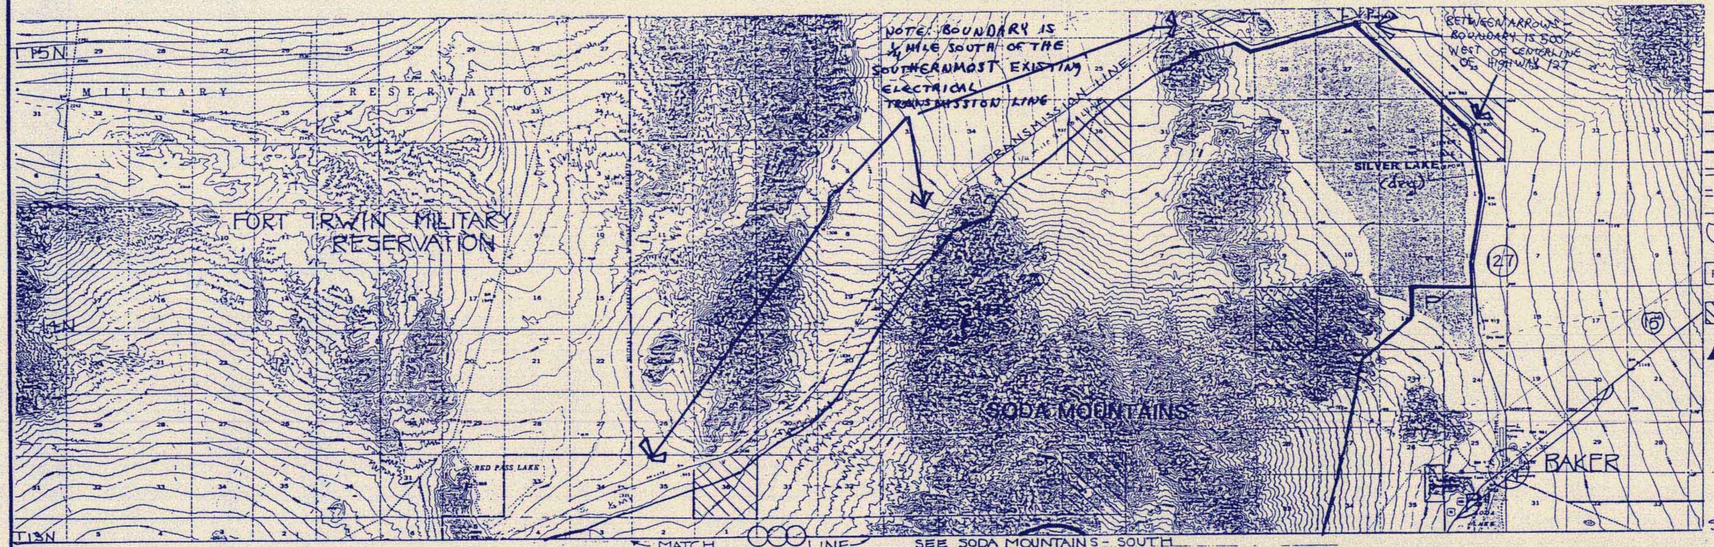

KEY

- PROPOSED BOUNDARY
- B.L.M PROPOSED BOUNDARY (NONE)
- COUNTY LINE
- STATE LINE
- ROADS
- UNIMPROVED DIRT TRACK
- MAJOR DRAINAGE
- INTERSTATE ROUTE
- OTHER ROUTES
- PRIVATE LAND
- BUREAU OF RECLAMATION
- STATE OF CALIFORNIA
- AREA OF SPECIAL CONCERN
- PEAK
- MINE

SCALE: 1" = 1 MILE

NORTH

USGS 15' TOPOS: BAKER, RED PASS LAKE

JAA

SODA MOUNTAINS WILDERNESS - PROPOSED

WILDERNESS STUDY AREA NO. 242

SHEET NO.	DATE
~~106~~ 94	May 91 ~~1-26-85~~ ~~5-17-85~~ ~~89~~ January 1989